



EXISTING SITE PLAN

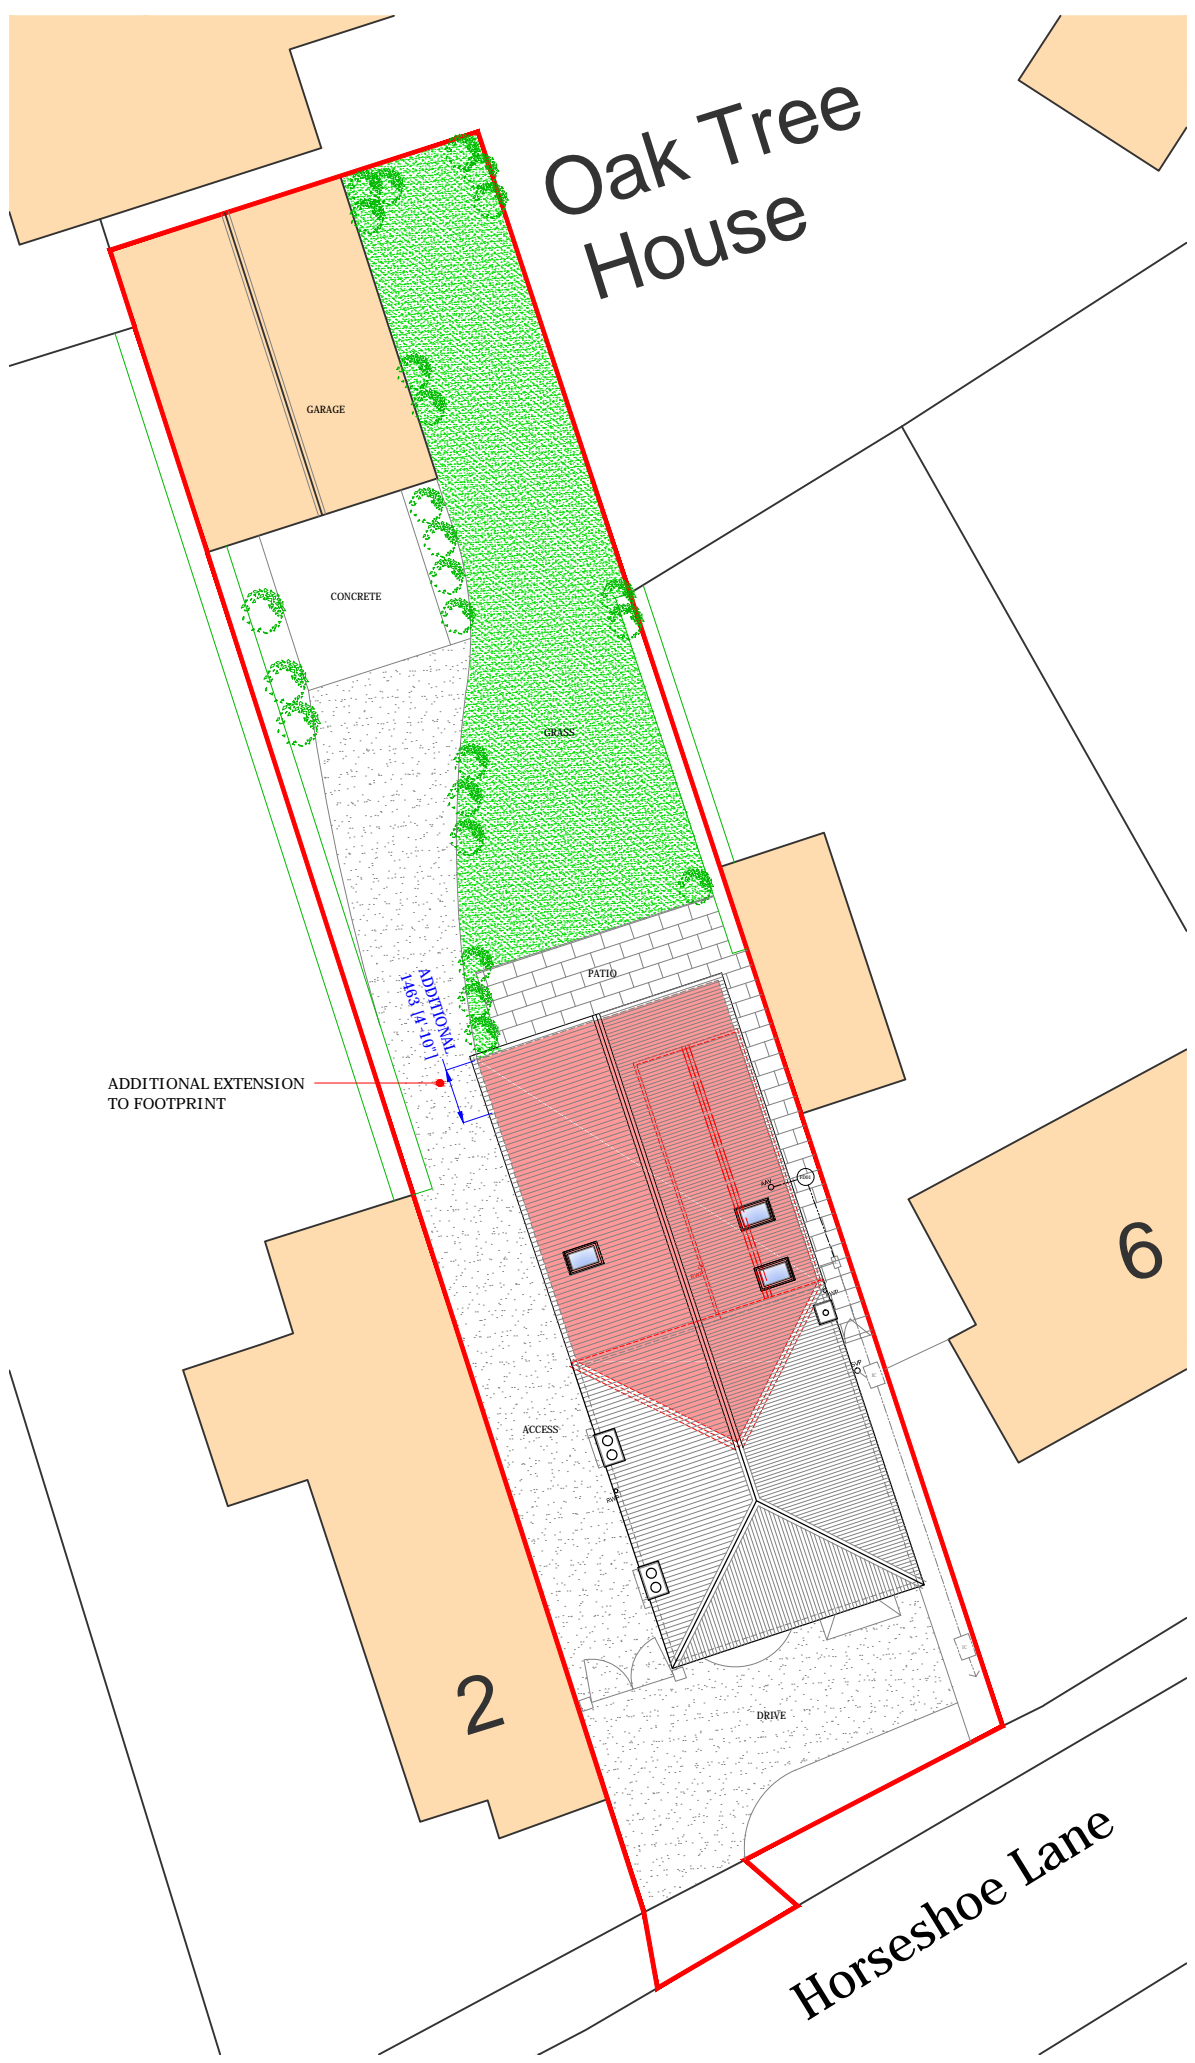

PROPSOED SITE PLAN

Copyright L.P.C Architectural Design.
Do Not Scale This Drawing

Notes:
- All dimensions to be checked & confirmed on site prior to commencement of works
- All structural elements to be checked & installed strictly in accordance with structural engineers & Manufactures details & specifications.
- All foul & surface water drainage systems to be checked & confirmed on site prior to commencement of works.

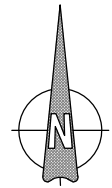

TO BE READ IN CONJUNCTION WITH PLANNING AND BUILDING REGULATION APPROVALS

C	ADDITIONAL 1.463M TO EXTENSION AS REQUESTED BY CLIENT. STEEL BEAM LOCATION ALTERED AND STUDWORK WALLS AT FIRST FLOOR MOVE TO SUIT STEEL POST POSITION	19-10-2021
B	EXISTING AND PROPOSED BELOW GROUND DRAINAGE SHOWN	31-08-2021
A	DETAILS UPDATED FOR BUILDING REGS PLAN CHECK APPLICATION	22-07-2021
REV	Note	Date



ARCHITECTURAL
DESIGN

07930 915730 lee@lpcdesign.co.uk
www.lpcdesign.co.uk

Project/Site	
EXTENSIONS AND ALTERATIONS	
No 4 Horseshoe Lane, Kirton Boston, Lincolnshire, PE20 1LJ	
Client	
Mr & Mrs Trotter	
Dwg Title	
EXISTING AND PROPOSED SITE PLANS	
Date	APRIL 2021
Scale	1:200 @ A3
Dwg No	LPC-273-03
Revision	C
Drawing Status	
PLANNING APPLICATION	